


LINE C URBAN LOOP

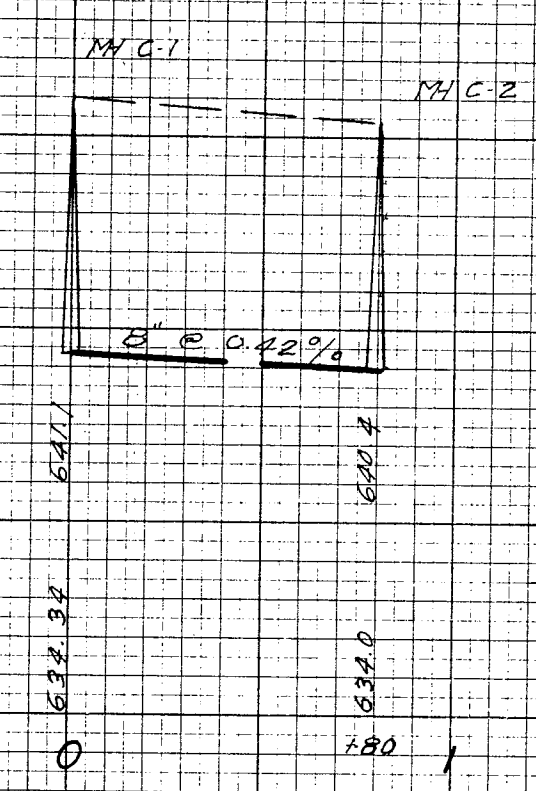

SCALE HORIZ 1"=50'
VERT 1"=5'


041-3052
2-3

AS BUILT

REVISIONS

DESIGNED BY
DRAWN BY H.B. 2.8.66
CHECKED BY
APPROVED BY

DRAWING No
JOB No. 34-RU-08

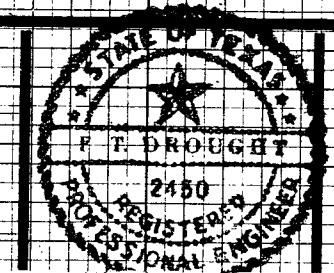

FRANK T. DROUGHT
CONSULTING ENGINEER

SAN ANTONIO, TEXAS

URBAN RENEWAL AGENCY
OF THE CITY OF SAN ANTONIO, TEXAS
TEX R-39, CENTRAL WEST AREA
PROJECT 1

SANITARY SEWERS

OF
SHEETS